


C:\Documents and Settings\MSMiller\Desktop\FortOrd_4108\New Folder\GeophysicalTestPlot1.mxd - 4/3/2008 @ 10:03:19 AM

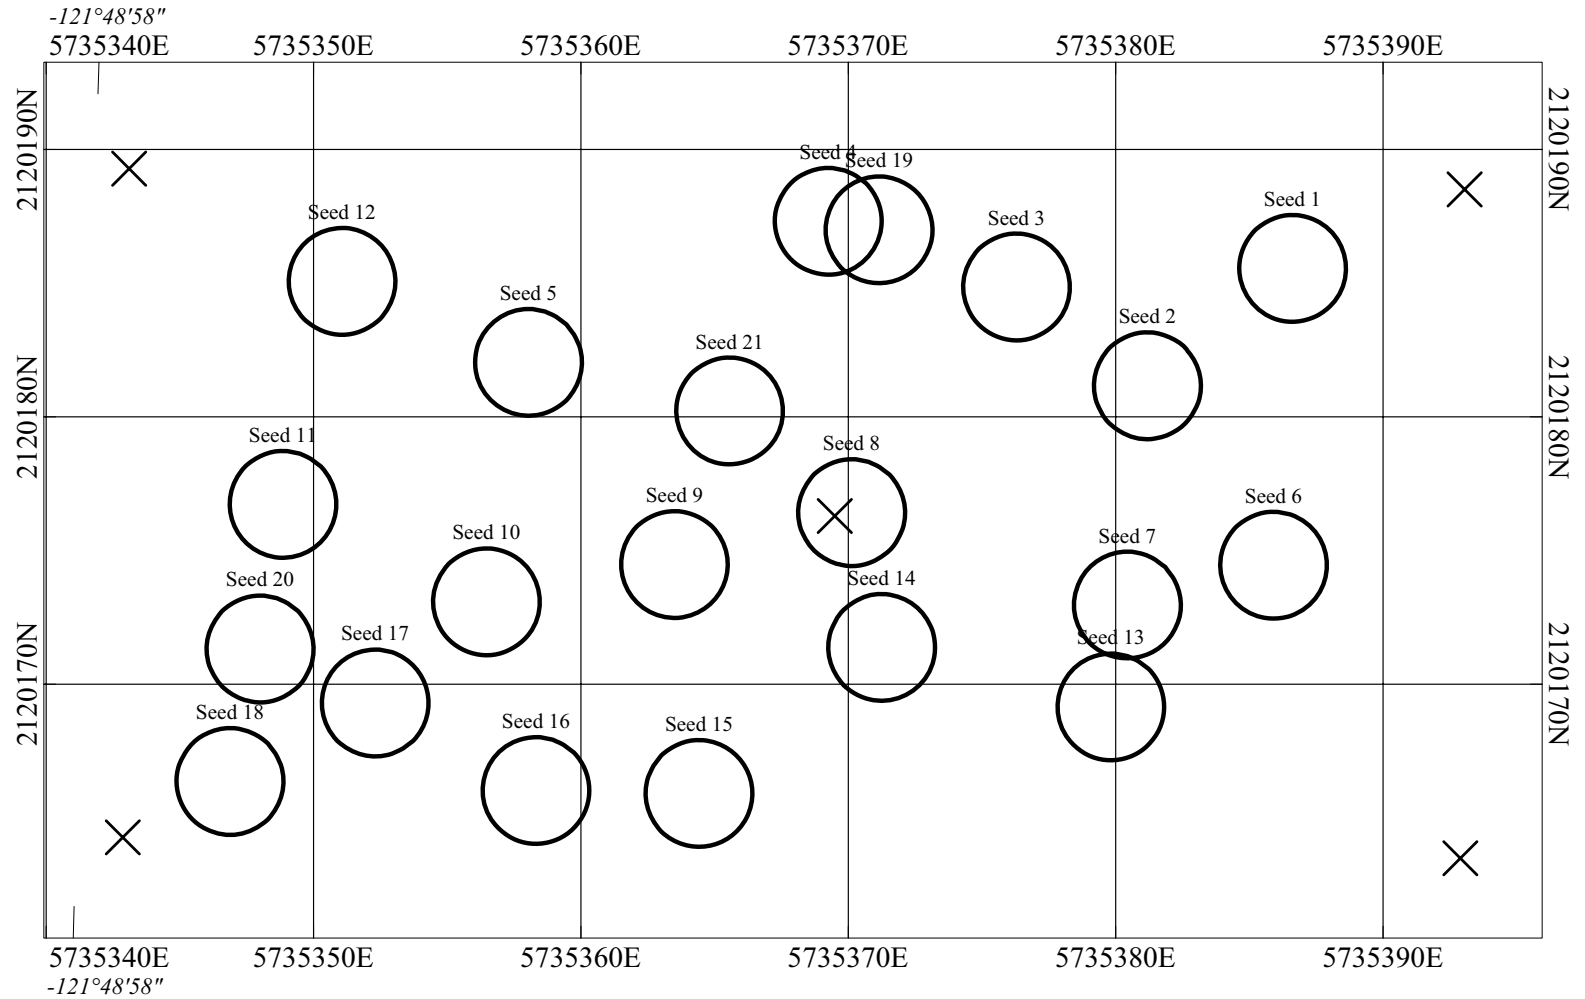

LEGEND

- X Grid Corner Seed
- O Seed Item

declination 14 degrees

Scale 1:90

US survey foot

NAD83 / California CS83 zone 4

Westcliffe Engineers, Inc.

Geophysical Test Plot 1
As-Built Seed Map
FORA ESCA RP
Monterey, County, California

Figure 2