


C:\Documents and Settings\MSMiller\Desktop\FortORD\_4108\New Folder\GeophysicalTestPlot1.mxd - 4/2/2008 @ 11:18:39 AM

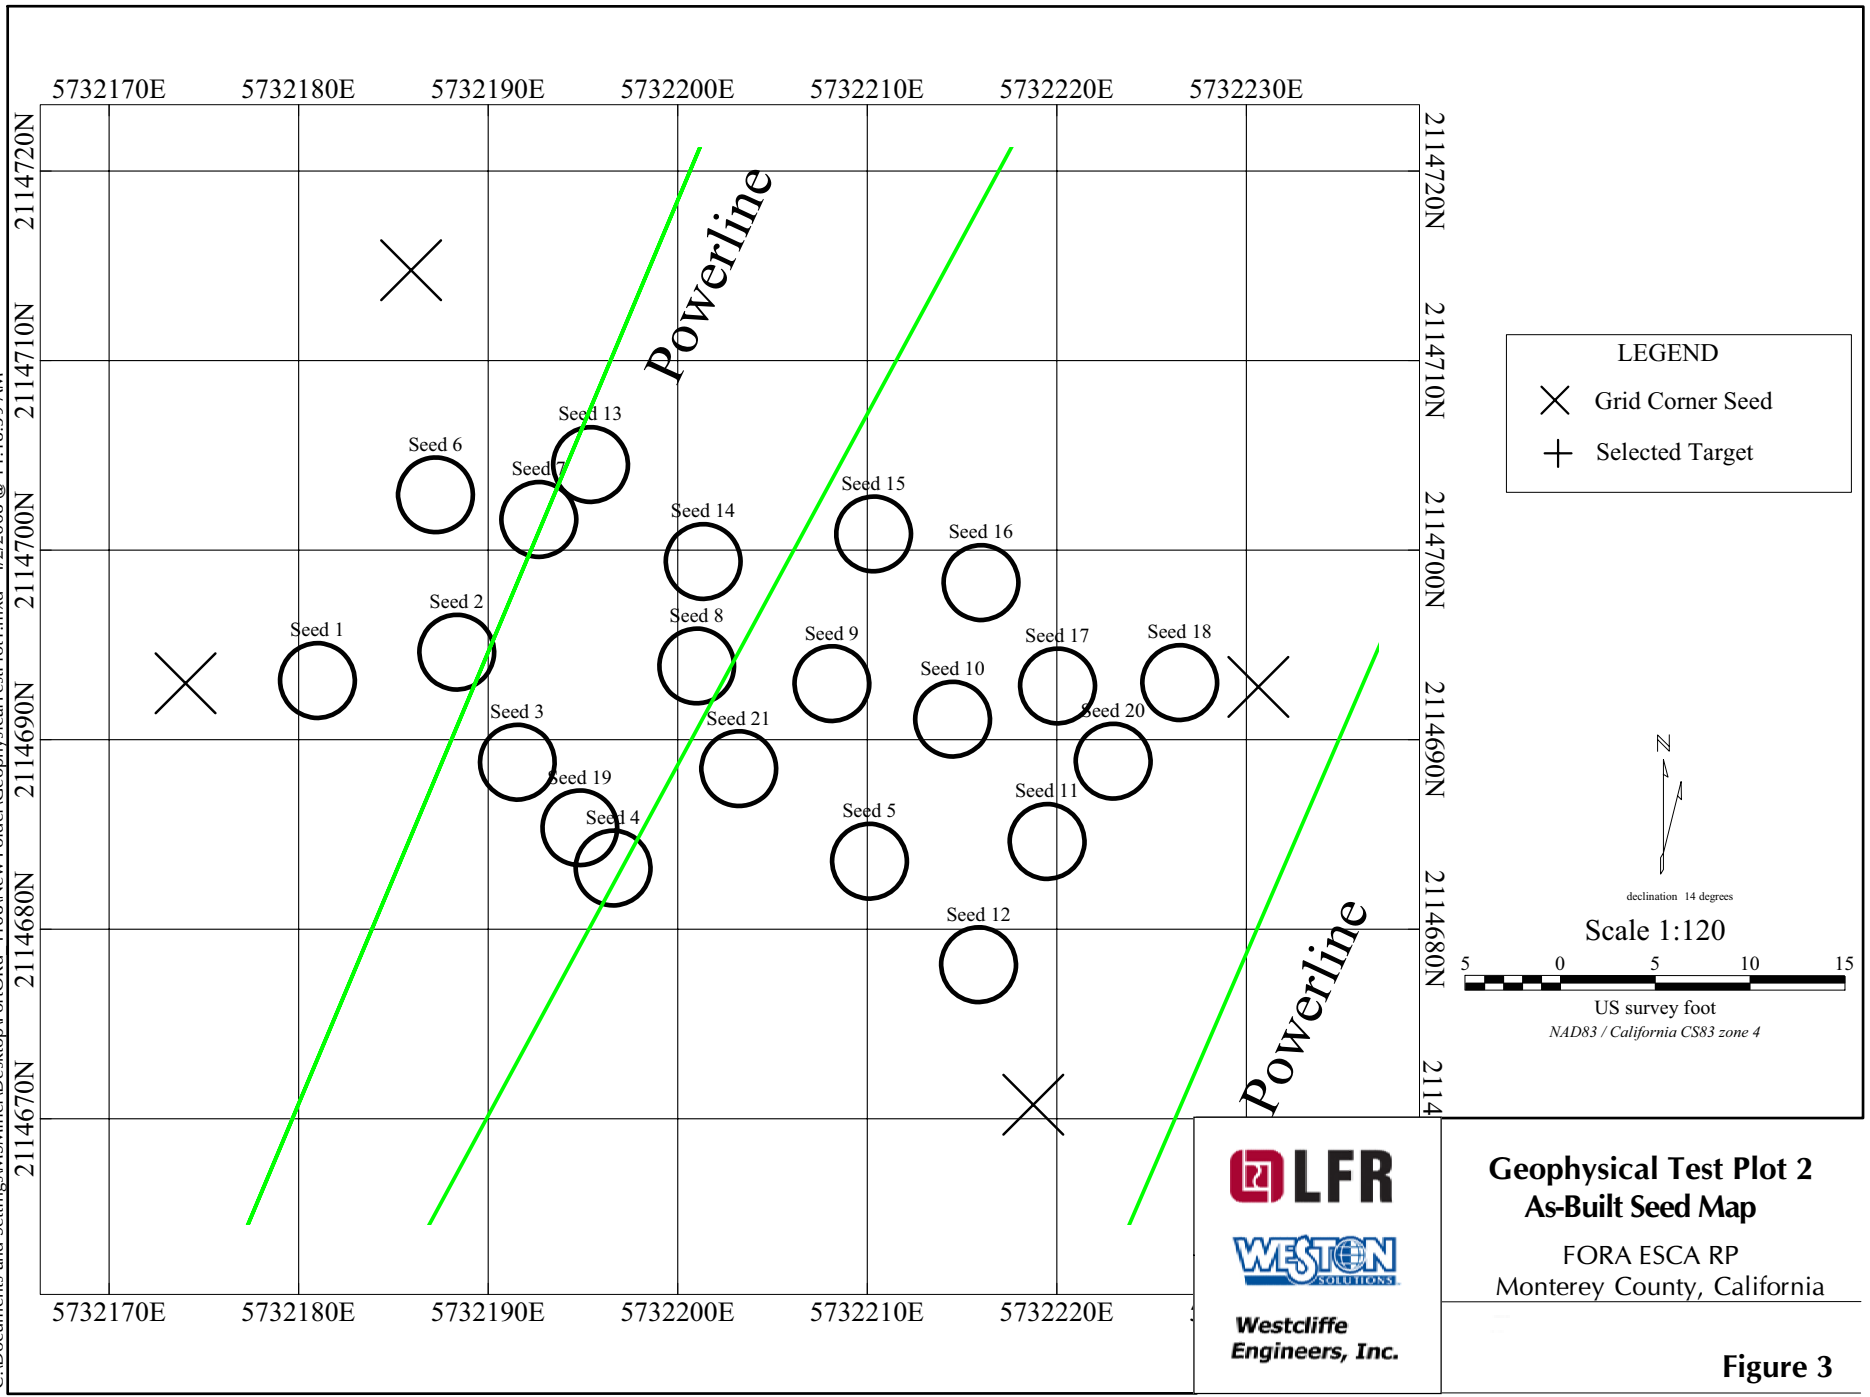

**LEGEND**

- × Grid Corner Seed
- + Selected Target

North Arrow  
declination 14 degrees

**Scale 1:120**

5 0 5 10 15

US survey foot  
NAD83 / California CS83 zone 4

**LFR**

**WESTON SOLUTIONS**

**Westcliffe Engineers, Inc.**

**Geophysical Test Plot 2  
As-Built Seed Map**

FORA ESCA RP  
Monterey County, California

**Figure 3**